

**CITY OF MERCED PROJECT CP190043
CHANGE ORDER NO. 1**

DATE: March 22, 2024

PROJECT NAME: CMAQ (049) Motel Drive

PROJECT LOCATION: Merced, California

CONTRACTOR: Redstone Construction, Inc.

ADDRESS: 1084 Shaffer Road, Atwater, CA 95301

REASON FOR CHANGE ORDER: Extra work for added driveways, curb and gutter adjustment to remove from joints, curb-ramp replacement with cross gutter, retaining curb for retaining soil behind new sidewalks, and modified fencing.

THE NUMBER OF WORKING DAYS WILL BE ADJUSTED AS FOLLOWS:

20

SKETCH ATTACHED: Yes

Extra Line Item Cost					
		Unit	Quantity	Unit Price	Amount
1	Install 8" Solid Wall Pipe	LF	296	\$ 37.00	\$ 10,952.00
2	Install 8" Drain Pipe	LF	273	\$ 42.00	\$ 11,466.00
3	Concrete Commercial Driveway	SF	132	\$ 18.00	\$ 2,376.00
4	Concrete Cross Gutter	SF	28	\$ 22.00	\$ 616.00
5	Remove Concrete Curb & Gutter	LF	43	\$ 25.00	\$ 1,075.00
6	Curb & Gutter	LF	43	\$ 83.00	\$ 3,569.00
7	Remove AC pavement	SF	2990	\$ 2.00	\$ 5,980.00
8	Asphalt Pavement (4" AC/15.5" AB)	SF	2990	\$ 13.00	\$ 38,870.00
9	Drain rock	SF	4125	\$ 6.00	\$ 24,750.00
					\$ 99,654.00

Extra Item Cost					
		Unit	Quantity	Unit Price	Amount
1	Install Concrete Drain Inlet	LS	3	\$ 5,500.00	\$ 16,500.00
2	Install Concrete Headwall	LS	17	\$ 1,900.00	\$ 32,300.00
					\$ 48,800.00

Cost Savings					
		Unit	Quantity	Unit Price	Amount
1	Concrete Multi-Use Path & Access Ramps	SF	-132	\$ 11.00	\$ (1,452.00)
2	Modified A1-8 Median Curb	LF	-9	\$ 45.00	\$ (405.00)
3	Relocate 12' Chain Link Rolling Gate	EA	-1	\$ 1,200.00	\$ (1,200.00)
4	Relocate 20' Chain Link Rolling Gate	EA	-1	\$ 1,500.00	\$ (1,500.00)
5	Relocate 30' Chain Link Rolling Gate	EA	-1	\$ 1,800.00	\$ (1,800.00)
6	Remove Chain Link Fence	LF	-360	\$ 10.00	\$ (3,600.00)
8	Chain Link Fence	LF	-360	\$ 55.00	\$ (19,800.00)
9	Monumentation	EA	-2	\$ 2,900.00	\$ (5,800.00)
					\$ (35,557.00)

Total for Change Order: \$ 112,897.00

ORIGINAL CONTRACT AMOUNT: \$ 993,059.00
CHANGE ORDER #1 AMOUNT: \$ 112,897.00
TOTAL PROJECT COST TO DATE: \$ 1,105,956.00

FUNDS/ACCOUNTS VERIFIED:

CP190043-MV20-20086015-591101 \$67,258.58
 CP190043-MV80-20096015-591101 \$45,638.42

ACCEPTED

(CONTRACTOR)

DATE:

5-2-24


RECOMMENDED

(INTERIM CITY ENGINEER)

DATE:

6/6/24

RECOMMENDED

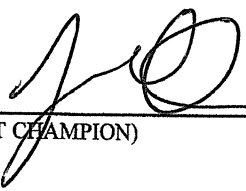

(PROJECT CHAMPION)

DATE:

6-21-24

APPROVED

As To Form

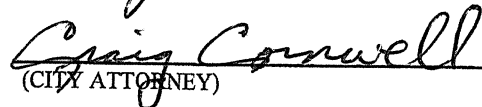
(CITY ATTORNEY)

DATE:

6-21-24

AUTHORIZED

(CITY MANAGER)

DATE:

ATTESTED

(ASSISTANT/DEPUTY CITY CLERK)

DATE:

(SEAL)



CHANGE ORDER REQUEST

Mailing Address:
PO Box 665
Atwater, CA 95301
209-921-3200
Fax: 358.7125

Date: 8/21/2023
From: Chris Gonzales
To: City of Merced
Attn: Paul Flores

Project: Motel Drive

COR Number: _____

Re: _____

This Change Order Request (COR) contains a quotation for a change in the contract sum or the contract time in response to proposed modifications to the contract documents based on field order request # _____ 1

Description of Change:

1. Installation of concrete drain inlet. 3 Each / \$5,500.00 Total: \$16,500.00

2. Installation of concrete headwall. 17 Each / \$1,900.00 Total: \$32,300.00

~~3. Installation of 8" SDR 26 perf pipe. 578 FT / \$42.00 Total: \$24,276.00~~

~~4. Installation of 10" SDR 26 per pipe. 500 FT / \$57.00 Total: \$28,500.00~~

Total: **\$48,800.00**

~~1. Install 1 1/2" Drain rock. \$60.00 / Ton (installed)~~

Supporting information attached from:

Subcontractor _____

Supplier _____

Reason for Change:

Does proposed change involve a change in contract time? _____

Increase/Decrease Amount: _____

Does proposed change involve a change in contract sum? _____

Increase/Decrease Amount: _____

Notes:

Name:		Date:	
Signature:			



1 R ST. CONSTRUCTION PLAN

SCALE: 1" = 20'-0"



1 R ST. CONSTRUCTION PLAN

SCALE: 1" = 20'-0"



NTS



2
NTS



NTS

Underground Service Alert



**TWO DAYS
BEFORE
YOU DIG**

CALL: TOLL FREE 1 (800) 642-2444

NOTE:
ALL REFERENCES AND WRITTEN DIMENSIONS SHALL TAKE DIMENSIONS OVER SCALED DIMENSIONS AND SHALL BE VERIFIED ON THE SITE. ANY DISCREPANCY SHALL BE BROUGHT TO NOTICE OF THE ENGINEER PRIOR TO THE COMMENCEMENT OF ANY WORK.



REVISION SIDEWALK WITH CURB


**PROJECT NO. 119069
CMAQ (050) SIDEWALKS
S. R ST, S. S ST, S. T ST
AND STUART DR.**

FILE NO. 1003

Sheet


1

Of 2

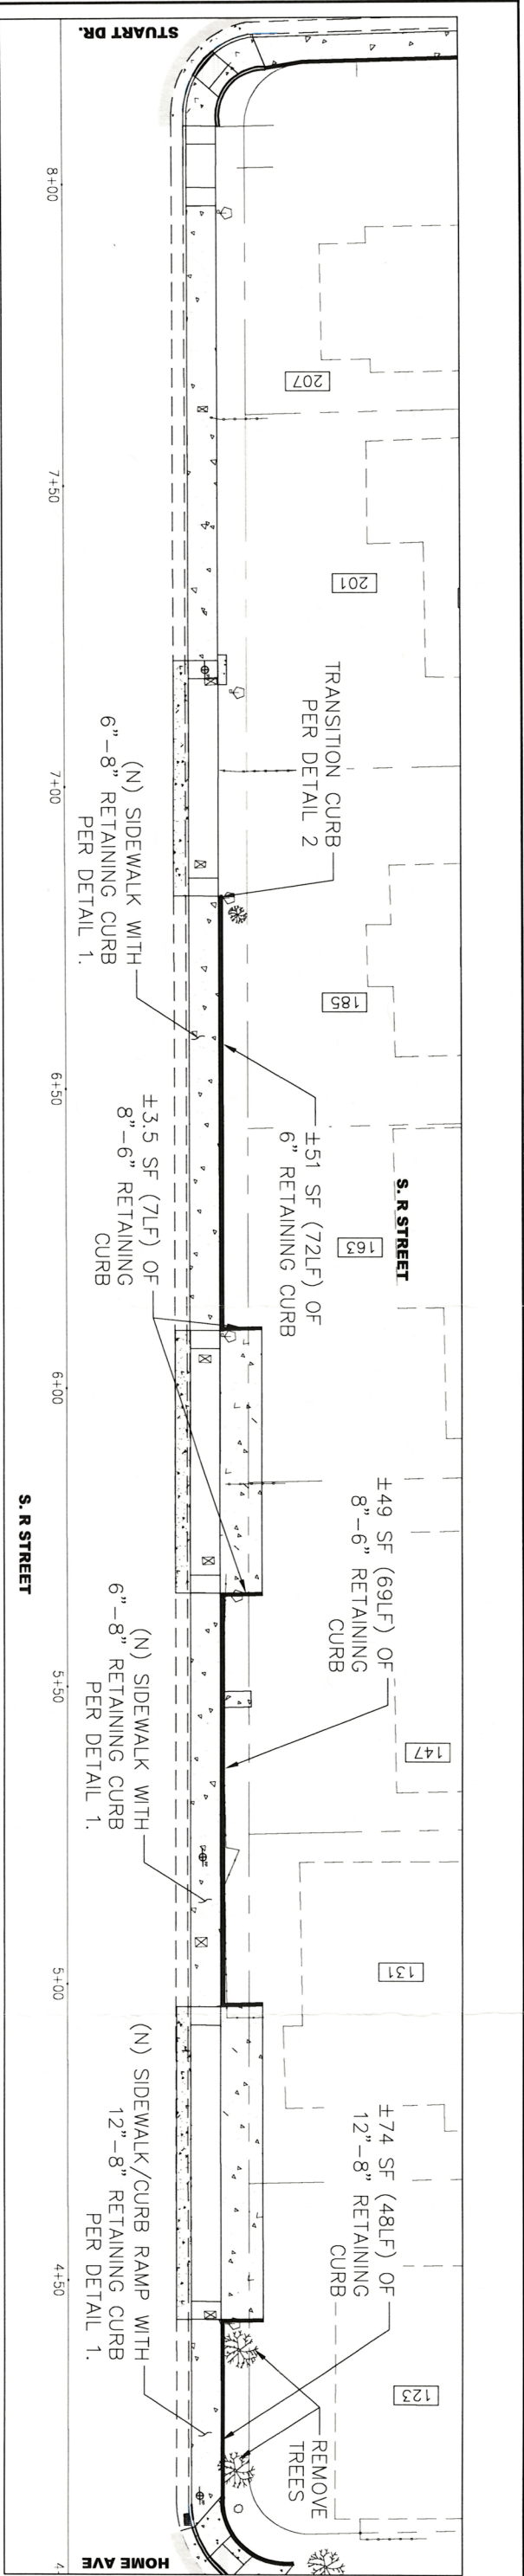


R STREET PLAN

SCALE: NTS

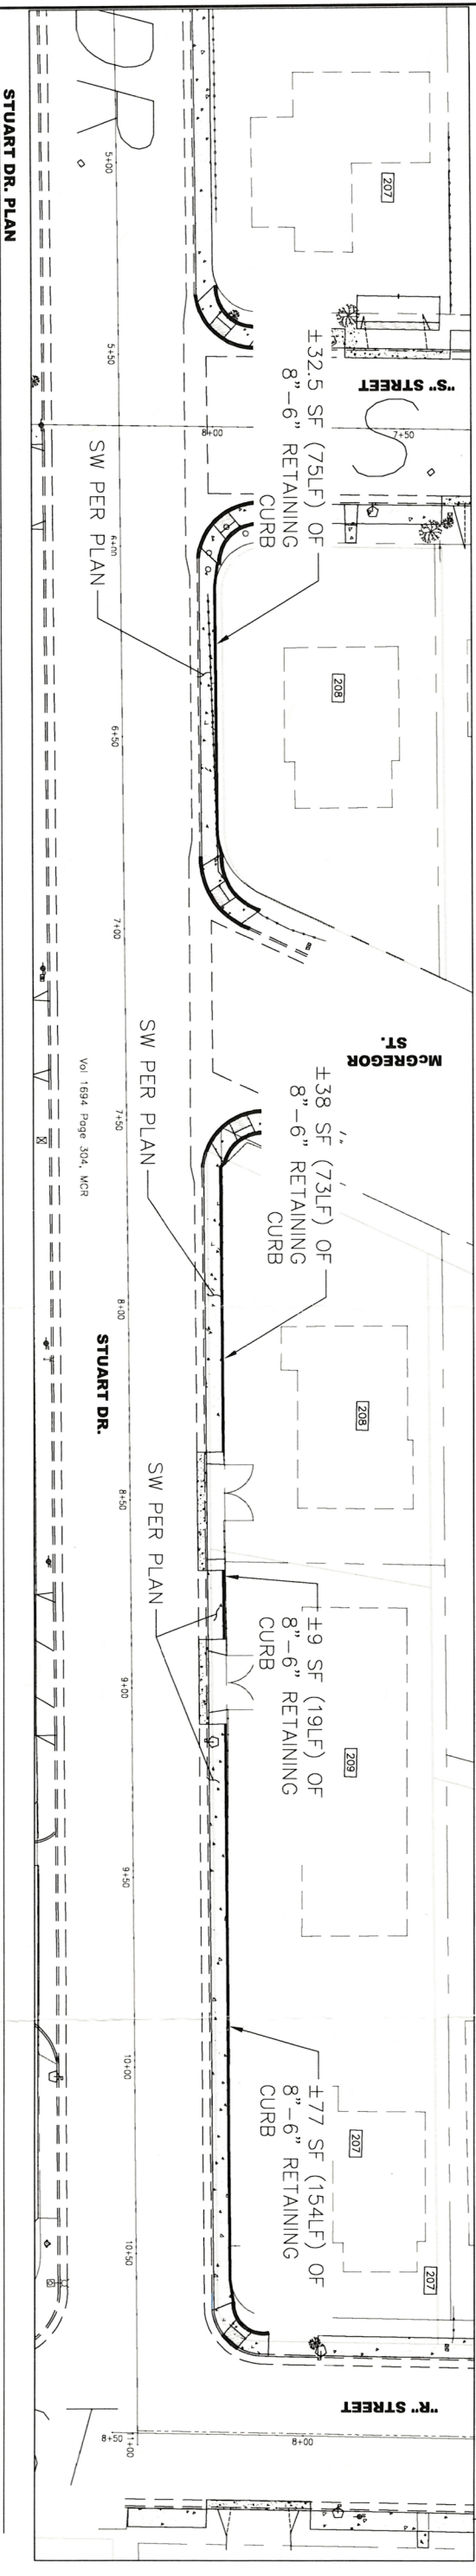


STUART DR. PLAN

SCALE: NTS

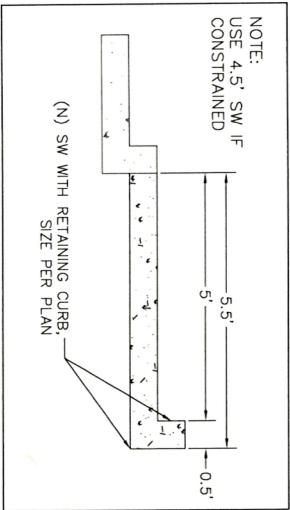

1 SIDEWALK WITH CURB
NTS

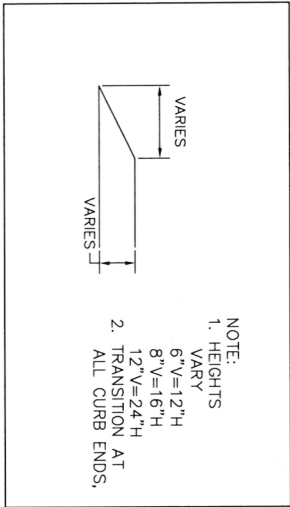

2 CURB TAPER
NTS

NO.	DATE	BY	REVISION MADE
1	09/22/22	PAF	CONSTRUCTION REQUIREMENTS

Underground Service Alert

TWO DAYS BEFORE YOU DIG

Call: TOLL FREE 1 (800) 642-2444

NOTE:
ALL REFERENCES AND WRITTEN DIMENSIONS SHALL TAKE PREFERENCE OVER SCALED DIMENSIONS. ANY DISCREPANCY SHALL BE BROUGHT TO NOTICE OF THE ENGINEER PRIOR TO THE COMMENCEMENT OF ANY WORK.

City of Merced

DEPARTMENT OF ENGINEERING

ENGINEERING PROJECTS AND STANDARDS

678 W. 18th Street (209) 395-6946

REVISION

SIDEWALK WITH CURB

PROJECT NO. 119069

CMAQ (050) SIDEWALKS

S. R ST, S. S ST, S. T ST AND STUART DR.

DESIGNED BY: A. YANG
DATE: 03/02/2021
CH. BY: ENGR DEPT
DATE: AUGUST 2022
REV DATE: --/--/--
SCALE: AS SHOWN

FILE NO. 1003

Sheet

2

OF 2