ATTACHMENT 6

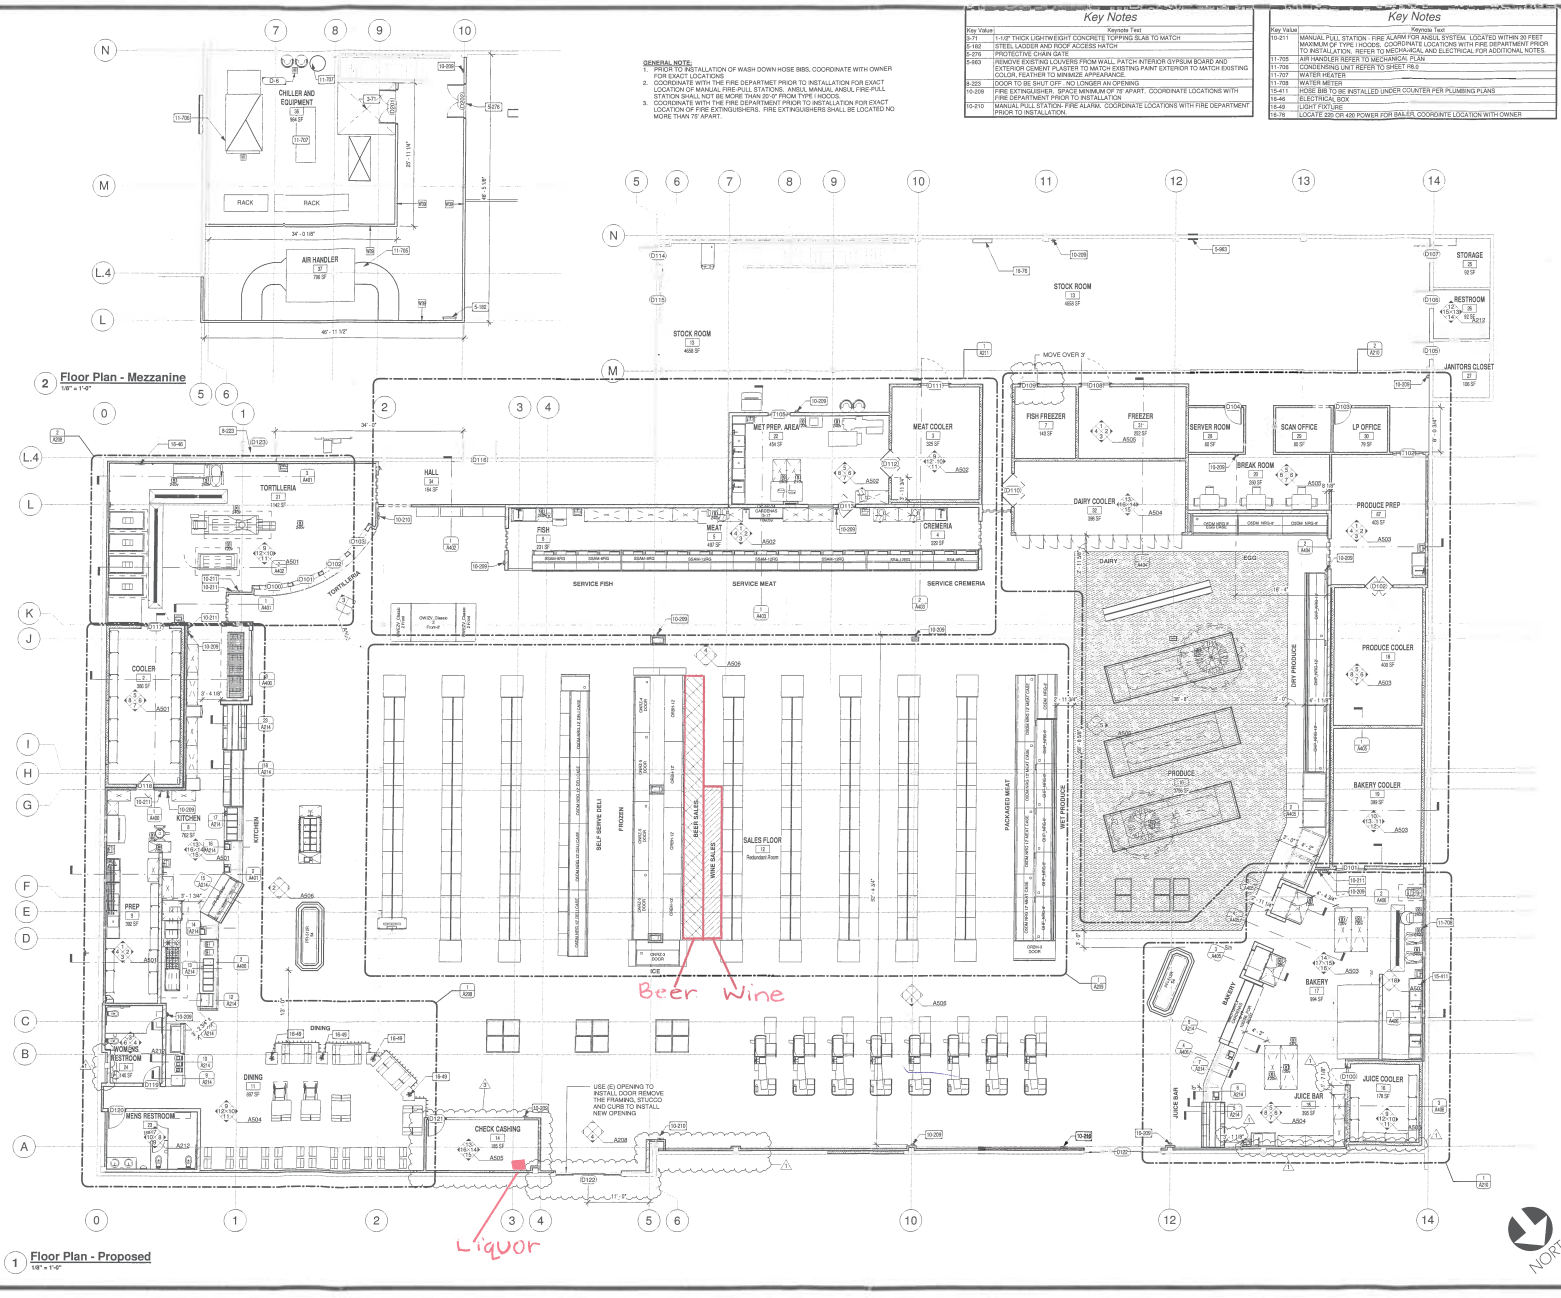

2 Floor Plan - Mezzanine
1/8" = 1'-0"

1 Floor Plan - Proposed
1/8" = 1'-0"

GENERAL NOTE:
1. PRIOR TO INSTALLATION OF WASH DOWN HOSE BIBS, COORDINATE WITH OWNER FOR EXACT LOCATIONS
2. COORDINATE WITH THE FIRE DEPARTMET PRIOR TO INSTALLATION FOR EXACT LOCATION OF MANUAL FIRE-PULL STATIONS, ANSUL MANUAL ANSUL FIRE-PULL STATION SHALL NOT BE MORE THAN 20'-0" FROM TYPE I HOODS.
3. COORDINATE WITH THE FIRE DEPARTMENT PRIOR TO INSTALLATION FOR EXACT LOCATION OF FIRE EXTINGUISHERS. FIRE EXTINGUISHERS SHALL BE LOCATED NO MORE THAN 75' APART.

Key Notes

Key Value	Keynote Text
3-71	1-1/2" THICK LIGHTWEIGHT CONCRETE TOPPING SLAB TO MATCH
5-162	STEEL LADDER AND ROOF ACCESS HATCH
5-276	PROTECTIVE CHAIN GATE
5-863	REMOVE EXISTING LOUVERS FROM WALL, PATCH INTERIOR GYPSUM BOARD AND EXTERIOR CEMENT PLASTER TO MATCH EXISTING PAINT EXTERIOR TO MATCH EXISTING COLOR, FEATHER TO MINIMIZE APPEARANCE.
8-223	DOOR TO BE SHUT OFF , NO LONGER AN OPENING
10-209	FIRE EXTINGUISHER. SPACE MINIMUM OF 75' APART. COORDINATE LOCATIONS WITH FIRE DEPARTMENT PRIOR TO INSTALLATION
10-210	MANUAL PULL STATION- FIRE ALARM. COORDINATE LOCATIONS WITH FIRE DEPARTMENT PRIOR TO INSTALLATION

Key Notes

Key Value	Keynote Text
10-211	MANUAL PULL STATION - FIRE ALARM FOR ANSUL SYSTEM. LOCATED WITHIN 30 FEET MAXIMUM OF TYPE I HOODS. COORDINATE LOCATIONS WITH FIRE DEPARTMENT PRIOR TO INSTALLATION. REFER TO MECHANICAL AND ELECTRICAL FOR ADDITIONAL NOTES.
11-705	AIR HANDLER REFER TO MECHANICAL PLAN
11-708	CONDENSING UNIT REFER TO SHEET M0.0
11-707	WATER HEATER
11-708	WATER METER
15-411	HOSE BIB TO BE INSTALLED UNDER COUNTER PER PLUMBING PLANS
16-46	ELECTRICAL BOX
16-49	LIGHT FIXTURE
16-76	LOCATE 220 OR 480 POWER FOR BAILER, COORDINTE LOCATION WITH OWNER

1664 N. 11TH ST. SUITE D
UPLAND, CA. 91710
909-262-9766
WWW.WSCSDESIGN.COM
WSCS DESIGN

Revision		
Number	Description	Date
1	Construction Clarifications/Changes	6-28-2018
3	Field Changes	7-17-2018

Wall Legend

- 6 1/2" FOAM INSULATED WALL PANEL WALL, UNLESS NOTED, REFER TO OWNER
- 3 5/8" STEEL STUD 20GA @ 24" O/C
- 6" STEEL STUD 20GA 24" O/C
- EXISTING 8" CMU WALL
- EXISTING WALLS
- WALLS TO BE REMOVED

Symbol Legend

- KEY NOTE
- SECTION DETAIL HEAD
  - NUMBER
  - SHEET
- INTERIOR ELEVATION TAG
  - ROOM FINISH DIRECTION (SEE ROOM FINISH SCHEDULE)
  - VIEW REF. #
  - SHEET NUMBER
- DOOR TAG (SEE DOOR SCHEDULE)
- WINDOW TAG (SEE WINDOW SCHEDULE)
- CASE WORK TAG (WINDOW SCHEDULE)
- WALL TAG SEE WALL SCHEDULE
- WALL MATERIAL TAG SEE SCHEDULE
- ROOF MATERIAL TAG SEE SCHEDULE
- CEILING MATERIAL TAG SEE SCHEDULE
- FLOOR MATERIAL TAG SEE SCHEDULE
- GLAZING WALL TAG SEE SCHEDULE SHEET

EQUIPMENT SHEDULE SYMBOLS
(SEE FULL EQUIPMENT SCHEDULE SHEET)

- -CASES
- -EQUIPMENT
- -PLUMBING FIXTURE TAG
  - LABEL
  - CATEGORY
  - (E) or (D) Existing or Demo Tag
- LIGHTING FIXTURE TAG (SEE FULL EQUIPMENT SCHEDULE SHEET)
  - LABEL
  - CATEGORY
- DETAIL KEYNOTE
- CEILING TAG SEE CEILING SCHEDULE
  - FLOOR FINISH MATERIAL
- Room name
  - BASE FINISH
  - FLOOR FINISH
- Room name
  - ROOM TAG
- EXIT SIGN
- COMPRESSION STRUT

2nd Plan Check Corrections 5-15-2018

Grocery Market T.I. for:

Cardenas Market

17-906

3-1-2017

1136 W. Main St.
Merced, CA 95340

A203

Floor Plan

07-19-18